


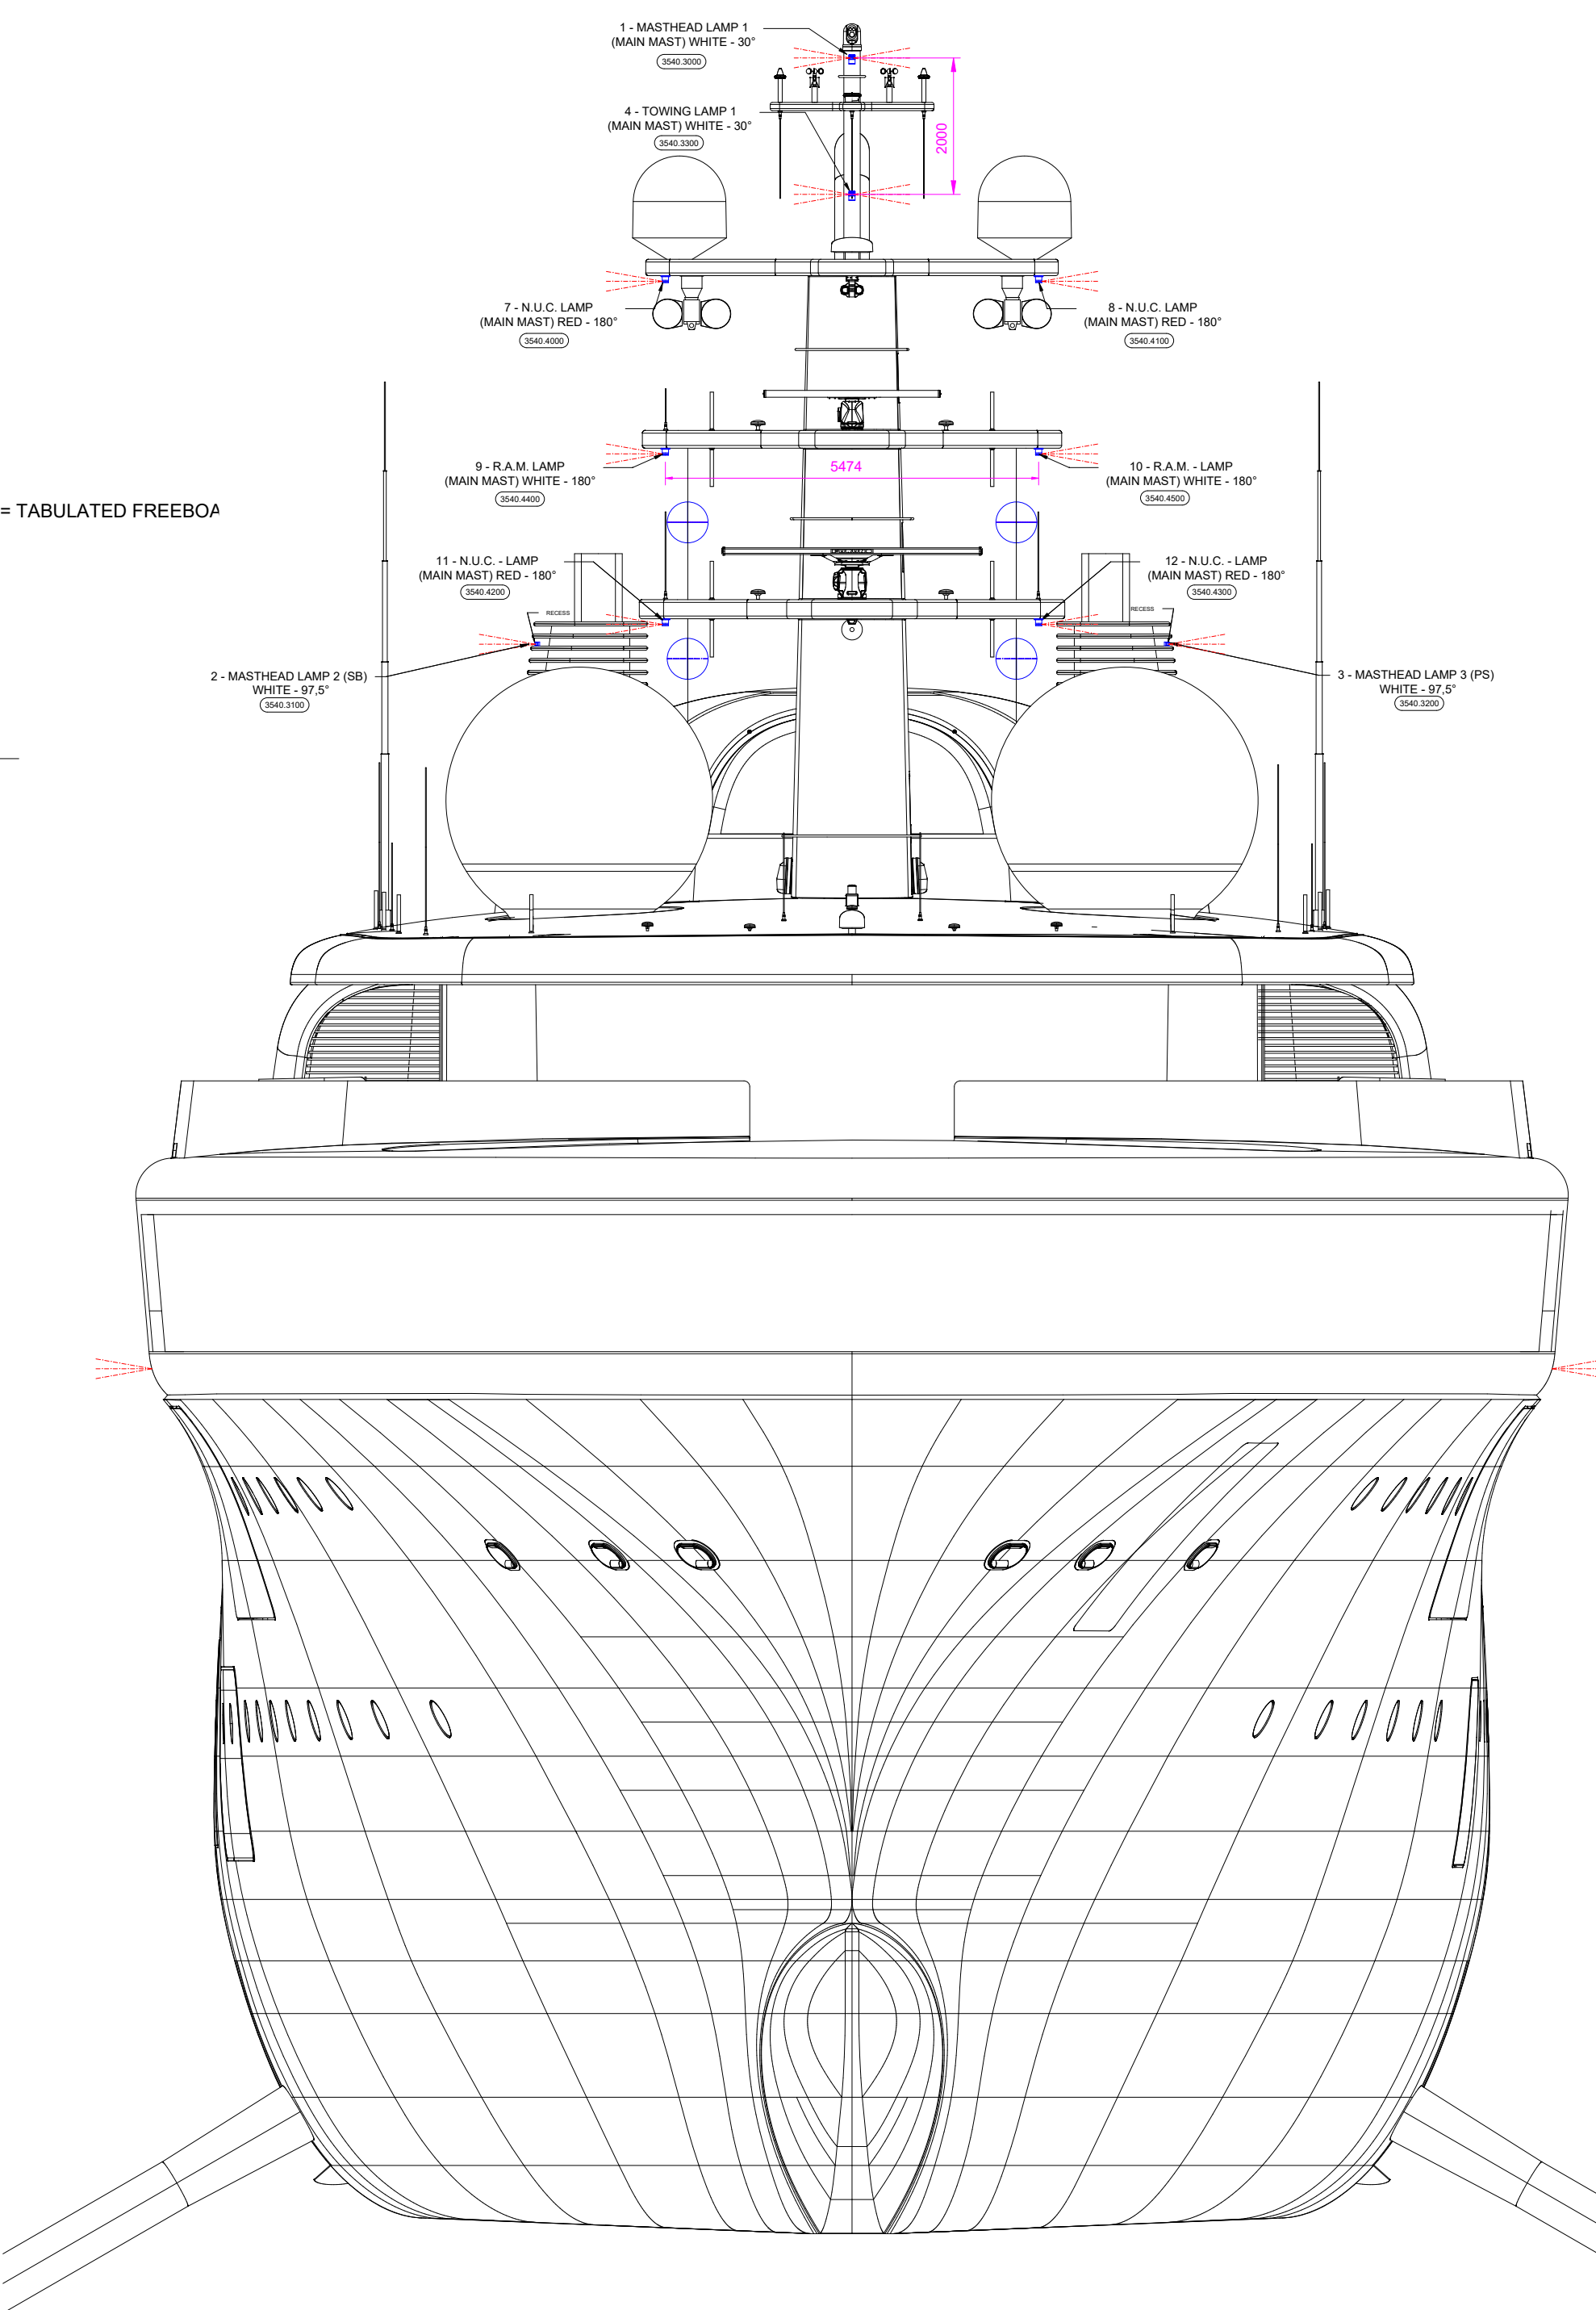

No.	DESCRIPTION	MOUNTING POSITION		SECTOR	LIGHT COLOR	SUPPLY	PART NO.	COLOR	TYPE	CABLE	BORP-NO.	VISIBILITY
1	WASTHEAD LANTERN 1	DOUBLE	MAIN MAST	30° (225°)	WHITE	24 V DC	300-139-30*	SILVER		15 m BACK	3540.3000	6 miles
2	WASTHEAD LANTERN 2	DOUBLE	FUNNEL STBD	97,5° (225°)	WHITE	24 V DC	300-138-PRO-EX	BLACK		15 m BACK	3540.3100	6 miles
3	WASTHEAD LANTERN 3	DOUBLE	FUNNEL PORT	97,5° (225°)	WHITE	24 V DC	300-138-PRO-EX	BLACK		15 m BACK	3540.3200	6 miles
4	TOWING LANTERN 1	DOUBLE	MAIN MAST	30° (225°)	WHITE	24 V DC	300-139-30*	SILVER		15 m BACK	3540.3300	6 miles
5	TOWING LANTERN 2	DOUBLE	FUNNEL STBD	97,5° (225°)	WHITE	24 V DC	300-138-PRO-EX	BLACK		15 m BACK	3540.3400	6 miles
6	TOWING LANTERN 3	DOUBLE	FUNNEL PORT	97,5° (225°)	WHITE	24 V DC	300-138-PRO-EX	BLACK		15 m BACK	3540.3500	6 miles
7	N.U.C. LANTERN	DOUBLE	MAIN MAST STBD UPPER	180°	RED	24 V DC	300-114023T-CD-180	SILVER		15 m TOP	3540.4000	3 miles
8	N.U.C. LANTERN	DOUBLE	MAIN MAST PORT UPPER	180°	RED	24 V DC	300-114023T-CD-180	SILVER		15 m TOP	3540.4100	3 miles
9	R.A.M. LANTERN	DOUBLE	MAIN MAST STBD MIDDLE	180°	WHITE	24 V DC	300-112023T-CD-180	SILVER		15 m TOP	3540.4400	3 miles
10	R.A.M. LANTERN	DOUBLE	MAIN MAST PORT MIDDLE	180°	WHITE	24 V DC	300-112023T-CD-180	SILVER		15 m TOP	3540.4500	3 miles
11	N.U.C. LANTERN	DOUBLE	MAIN MAST STBD LOWER	180°	RED	24 V DC	300-114023T-CD-180	SILVER		15 m TOP	3540.4200	3 miles
12	N.U.C. LANTERN	DOUBLE	MAIN MAST PORT LOWER	180°	RED	24 V DC	300-114023T-CD-180	SILVER		15 m TOP	3540.4300	3 miles
13	SIDE LANTERN	DOUBLE	SIDE STBD	112,5°	GREEN	24 V DC	301-1015T-B 6W	BLACK		6 m BACK	3540.5000	3 miles
14	SIDE LANTERN	DOUBLE	SIDE PORT	112,5°	RED	24 V DC	301-1025T-B 6	BLACK		6 m BACK	3540.5100	3 miles
15	ANCHOR / WASTHEAD LANTERN	DOUBLE	ANCHOR MAST	360° / 225°	WHITE / WHITE	24 V DC	300-138* 112023T-CD	SILVER		2 m BOTTOM	3540.6000	3/6 miles
16	ANCHOR / TOWING LANTERN	DOUBLE	STERN (TBD)	360° / 135°	WHITE / YELLOW	24 V DC	301-1135T+112023T	SILVER		6 m BOTTOM	3540.7000	3/3 miles
17	STERN LANTERN	DOUBLE	STERN (TBD)	135°	WHITE	24 V DC	301-1055T-CD	SILVER		6 m BOTTOM	3540.8000	3 miles
--	GONG (PORTABLE EQUIPMENT)	POSITION TBD		----	----	----	ZÖLLNER 500M	----		----	----	1100B (1m)
--	SHIP BELL	POSITION TBD		----	----	----	D=300mm	----		----	----	1100B (1m)

LENGTH OVER ALL	114,20m
BREADTH OVERALL	21,00m
DRAUGHT TO DWL	4,70m
DRAUGHT LOADLINE	4,80m

13759	3540	01.00
Neubau	Gruppe	Zeichnung

Lichterführungsplan